


(ROUTE 6)
NEW BEDFORD -
FAIRHAVEN BRIDGE

- GENERAL NOTES:**
- THE AS BUILT PIER INFORMATION SHOWN IS THE RESULT OF A FIELD SURVEY PERFORMED BY THIS OFFICE ON 1-22-18 WHICH REFLECTS ALL VISIBLE ELEMENTS OF THE PIER (ie: STEEL PILING SUPPORTS WERE NOT VISIBLE).
 - THE SUBJECT PIER WAS PERMITTED BY THE NEW BEDFORD CONSERVATION COMMISSION UNDER DEP FILE NO. SE 49-716.
 - THE SUBJECT PIER WAS PERMITTED BY THE DEP-WATERWAYS UNDER CHAPTER 91 WATERWAYS LICENSE NO. 14068.
 - THE SUBJECT PIER WAS PERMITTED BY THE U.S. ARMY CORP. OF ENGINEERS UNDER PERMIT NO. NAE-2015-01483.

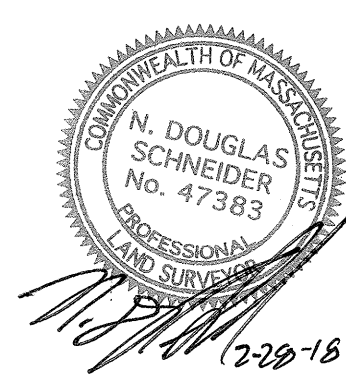

1	Rev. #	DATE	BY	DESCRIPTION
				PIER "AS BUILT" PLAN LOT #1 ON ASSESSORS MAP #60 at FISH ISLAND in NEW BEDFORD, MA. PREPARED FOR BRIDGE REAL ESTATE INVESTORS, LLC
		SCALE: 1"=20'		DATE: FEBRUARY 26, 2018
		0 10 20 40 60		
		N. Douglas Schneider & Associates, Inc. PROFESSIONAL CIVIL ENGINEERS & LAND SURVEYORS 1 COUNTY RD, P.O. BOX 480, MATTAPOISETT, MA 02739 1-508-758-7866		
		Drawn By: D.M.D.	Check By: N.D.S.	Job No. 2592