



NOTES

1. CONSTRUCTION OF BASIN PERFORMED BY CITY OF NEW BEDFORD DEPARTMENT OF PUBLIC INFRASTRUCTURE (DPI).
2. AS-BUILT TOPOGRAPHIC SURVEY PREPARED BY DPI (FILE: RETAINING POND_AS BUILT_UPDATED.DWG, RECEIVED ON 10/8/2014.
3. OUTLET CONTROL STRUCTURE AND 24-INCH DISCHARGE PIPE ELEVATIONS PROVIDED BY DPI IN AN EMAIL DATED 9/17/2014.
4. NITSCH ENGINEERING HAS REVIEWED THIS AS-BUILT INFORMATION PROVIDED BY DPI FOR CONSISTENCY WITH THE APPROVED PLANS AND CALCULATIONS FOR THE BISMARK MEADOWS SUBDIVISION. WE MAKE NO CLAIMS REGARDING THE ACCURACY OF THE AS-BUILT SURVEY AS IT WAS PERFORMED BY OTHERS. THE AS-BUILT INFORMATION, INCLUDING THE TOPOGRAPHIC SURVEY AND OUTLET INFORMATION PROVIDED BY DPI REPRESENTS GENERAL COMPLIANCE WITH THE APPROVED PLANS FOR BISMARK MEADOWS.

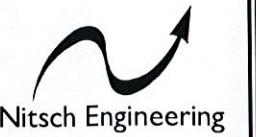

[Signature]
10/22/14

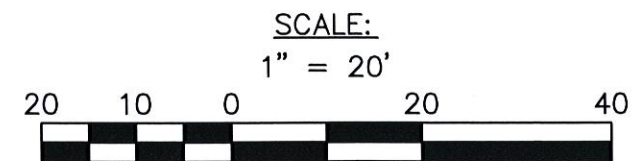

www.nitscheng.com
2 Center Plaza, Suite 430
Boston, MA 02108
T: (617) 338-0063
F: (617) 338-6472

- Civil Engineering
- Land Surveying
- Transportation Engineering
- Sustainable Site Consulting
- Planning
- GIS

BISMARK MEADOWS
DETENTION POND AS-BUILT
NEW BEDFORD, MASSACHUSETTS

PREPARED FOR:
CITY OF NEW BEDFORD
CONSERVATION COMMISSION

PROJECT # 9972
FILE: 9972BM-AB.DWG
SCALE: 1"=20'
DATE: 10-22-2014
PROJECT MGR: SDT
SURVEYOR:
DRAFTED BY: JLLJ
CHECKED BY: SDT

C-1