



Massachusetts Department of Environmental Protection
Bureau of Resource Protection - Wetlands
WPA Form 8A – Request for Certificate of Compliance
Massachusetts Wetlands Protection Act M.G.L. c. 131, §40


DEP File Number:

SE 049-0803
Provided by DEP

A. Project Information

Important:

When filling out forms on the computer, use only the tab key to move your cursor - do not use the return key.

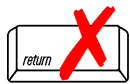

Upon completion of the work authorized in an Order of Conditions, the property owner must request a Certificate of Compliance from the issuing authority stating that the work or portion of the work has been satisfactorily completed.

1. This request is being made by:

City of New Bedford - Department of Environmental Stewardship

Name

Room 304 - City Hall, 133 William Street

Mailing Address

New Bedford

City/Town

MA
State

02740
Zip Code

Phone Number

2. This request is in reference to work regulated by a final Order of Conditions issued to:

City of New Bedford - Department of Environmental Stewardship

Applicant

February 6, 2020

Dated

SE 049-0803

DEP File Number

3. The project site is located at:

Ruggles Street & Hathaway Boulevard

Street Address

Map 69 and Nemasket Street Right of Way

Assessors Map/Plat Number

New Bedford

City/Town

86, 88-93, 96-100, and 125

Parcel/Lot Number

4. The final Order of Conditions was recorded at the Registry of Deeds for:

City of New Bedford

Property Owner (if different)

Bristol

County

9479; 3805; 849

Book

311; 244;

329

Certificate (if registered land)

5. This request is for certification that (check one):

☒ the work regulated by the above-referenced Order of Conditions has been satisfactorily completed.

☐ the following portions of the work regulated by the above-referenced Order of Conditions have been satisfactorily completed (use additional paper if necessary).

☐ the above-referenced Order of Conditions has lapsed and is therefore no longer valid, and the work regulated by it was never started.



Massachusetts Department of Environmental Protection

Bureau of Resource Protection - Wetlands

WPA Form 8A – Request for Certificate of Compliance

Massachusetts Wetlands Protection Act M.G.L. c. 131, §40

DEP File Number:

SE 049-0803

Provided by DEP

A. Project Information (cont.)

6. Did the Order of Conditions for this project, or the portion of the project subject to this request, contain an approval of any plans stamped by a registered professional engineer, architect, landscape architect, or land surveyor?

☒ Yes

If yes, attach a written statement by such a professional certifying substantial compliance with the plans and describing what deviation, if any, exists from the plans approved in the Order.

☐ No

B. Submittal Requirements

Requests for Certificates of Compliance should be directed to the issuing authority that issued the final Order of Conditions (OOC). If the project received an OOC from the Conservation Commission, submit this request to that Commission. If the project was issued a Superseding Order of Conditions or was the subject of an Adjudicatory Hearing Final Decision, submit this request to the appropriate DEP Regional Office (see <http://www.mass.gov/eea/agencies/massdep/about/contacts/find-the-massdep-regional-office-for-your-city-or-town.html>).



650 Suffolk St., Suite 200
Lowell, MA 01854

T 978.970.5600
TRCcompanies.com

TRC Project Number: 281331

December 3, 2020

Bruce C. Hebbel, P.G.
Dept. of Environmental Stewardship
City of New Bedford
133 William Street, Room 304
New Bedford, Massachusetts 02740

RE: Certificate of Compliance – Nemasket Street Remediation/Field Construction
Project – MADEP File #SE 049-0802
Parker Street Waste Site (PSWS) – Release Tracking Number 4-15685

Dear Mr. Hebbel:

I certify that the proposed work presented in the Notice of Intent for the Nemasket field project has been completed in substantial compliance with the plans approved by the New Bedford Conservation Commission. The attached as-built plans identify the final configuration of the field and surrounding area..



Please contact me at (978) 995-9301 or jdoherty@trccompanies.com with any questions or further needs.

Sincerely,

A handwritten signature in dark ink, appearing to read "J. Doherty", written in a cursive style.

James Doherty, PhD, PE
Sr. Hydrogeologist

attachment

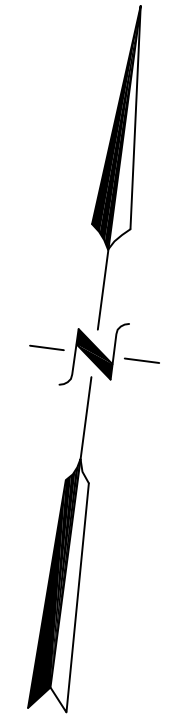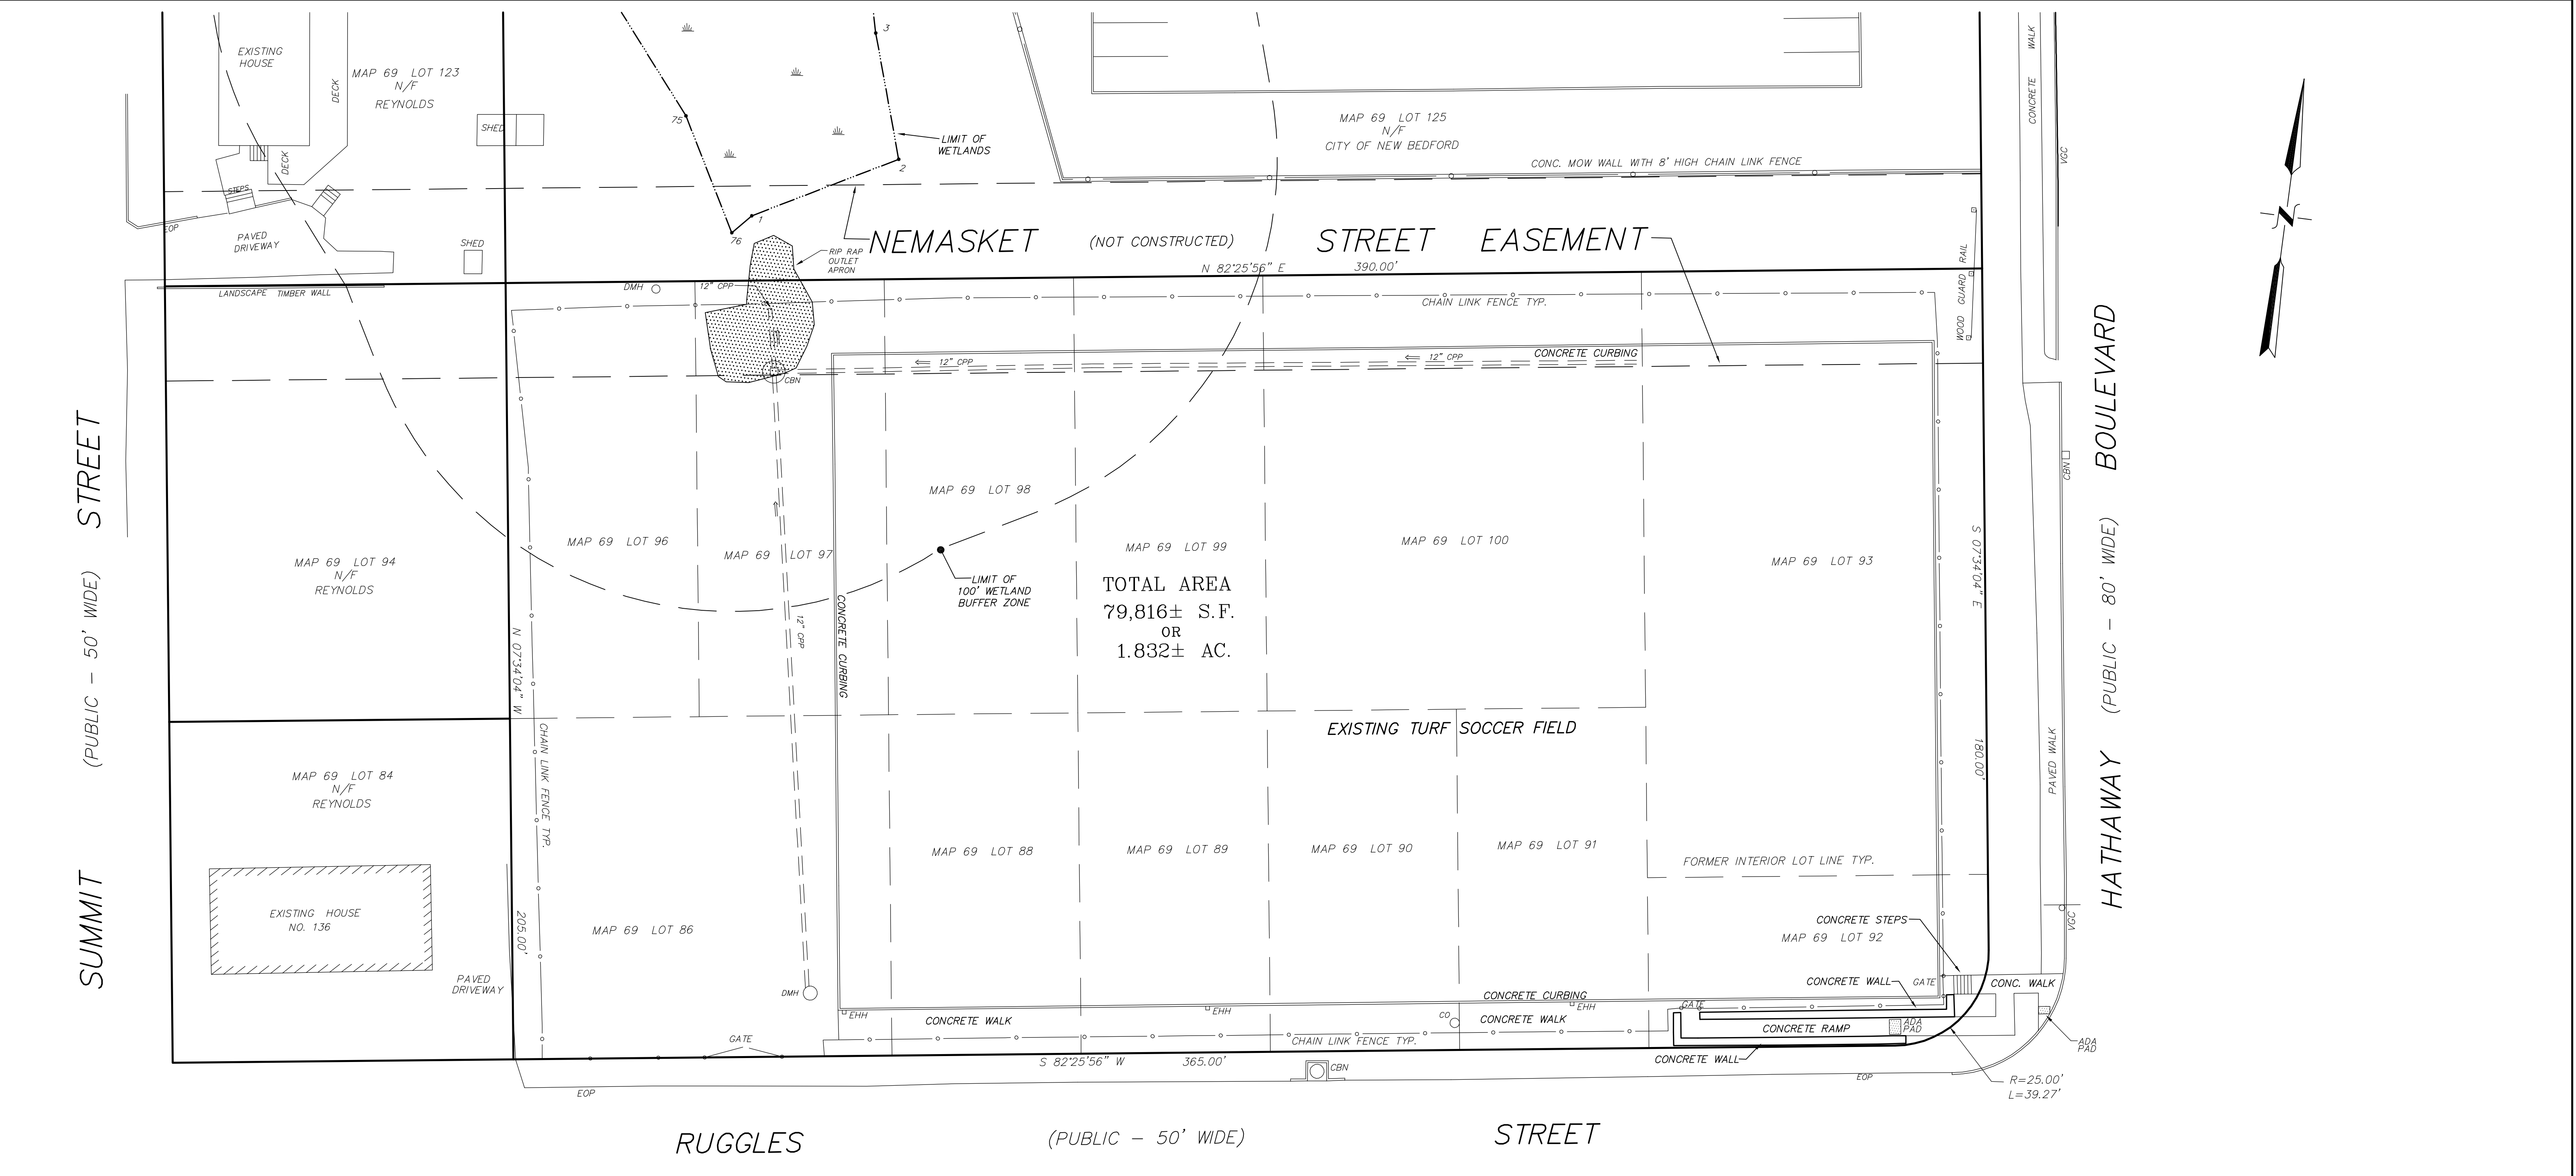


LEGEND

- EXISTING LOT LINES AND STREET LINES
- FORMER LOT LINES

GENERAL NOTES:

- 1. LOT SUMMARY
- 2. PLAN REFERENCE: PL. BK. 154 PG. 24
- 3. BRISTOL COUNTY REGISTRY OF DEEDS (SOUTHERN DISTRICT.)

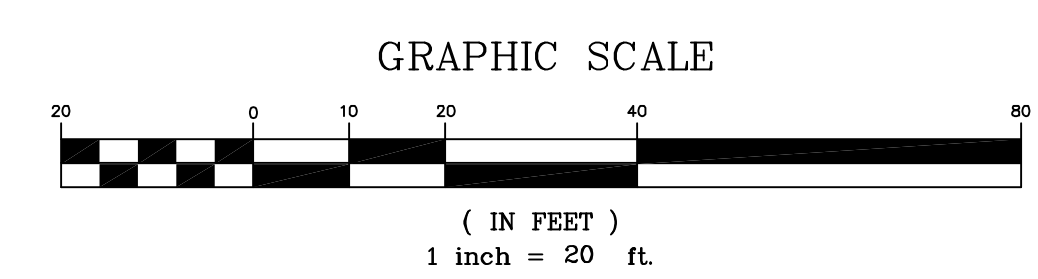

CONSERVATION ASBUILT
PLAN OF LAND
LOCATED AT
NEMASKET STREET LOTS
NEW BEDFORD, MASSACHUSETTS
OWNED BY
CITY OF NEW BEDFORD
NOVEMBER 13, 2020

LAND PLANNING, INC.

HANSON: 1115 MAIN STREET 02341 (781) 294-4144

BELLINGHAM: 167 HARTFORD AVE. 02019 (508) 966-4130

N. GRAFTON: 214 WORCESTER ST. 01536 (508) 839-9526

CALCS G.R.RICE	JOB NO. P-3120	DWG NAME P3120-AUL-RUGGLES	SHEET NO. 1 OF 1
-------------------	-------------------	-------------------------------	---------------------